
AS BUILT – DYNAMIC DRAINAGE & EXCAVATION LTD

GRANT WOOSTER REGO # 19643 BCN # 260549 DATE: 04/05/26

ADDRESS: 115 Solihull dr, Rolleston

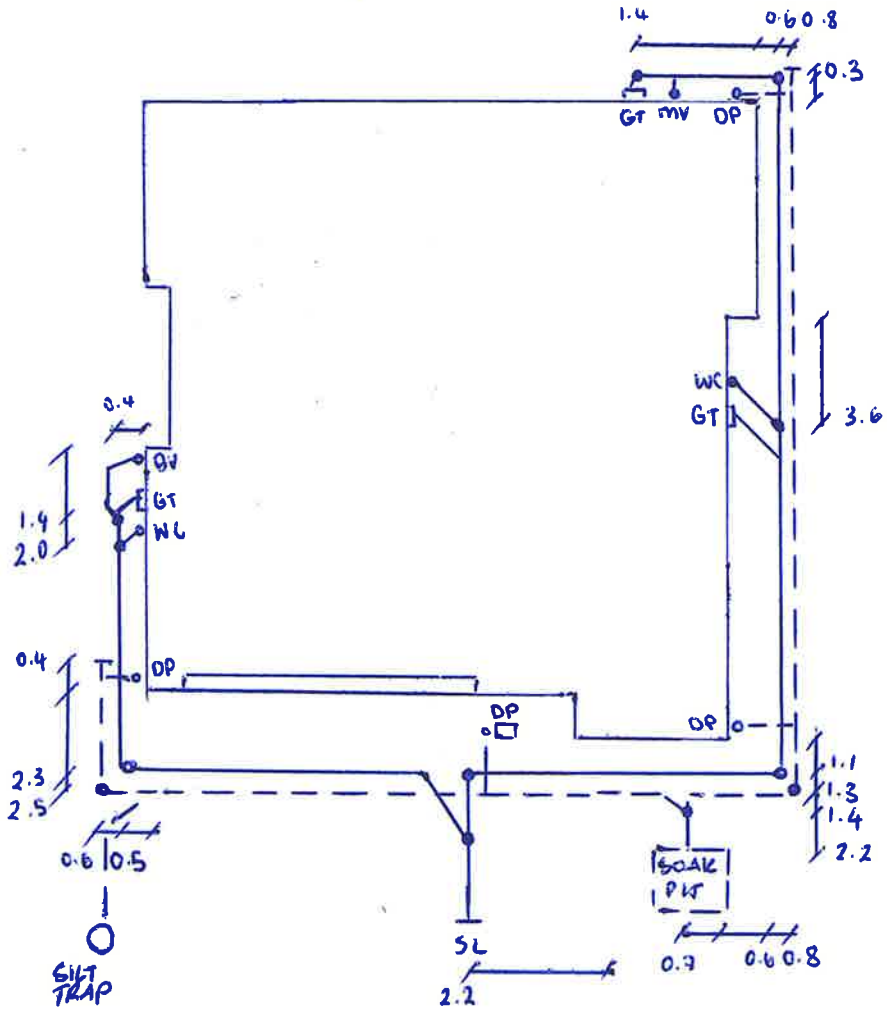

KEY

SEWER ———————

STORMWATER - - - - - - - - - - - - - - - - -

INSPECTION •

RODDING POINTS ⊢

**NOT TO SCALE **

SEWER GRADE 1: 60 SEWER DEPTH AT BOUNDARY 1.0m

STORMWATER GRADE 1: 100 STORMWATER DEPTH AT BOUNDARY 1.0m