
Drainlayer T. Bailey 07749.
Robertson House
10 Leicester Pl
Springvale.

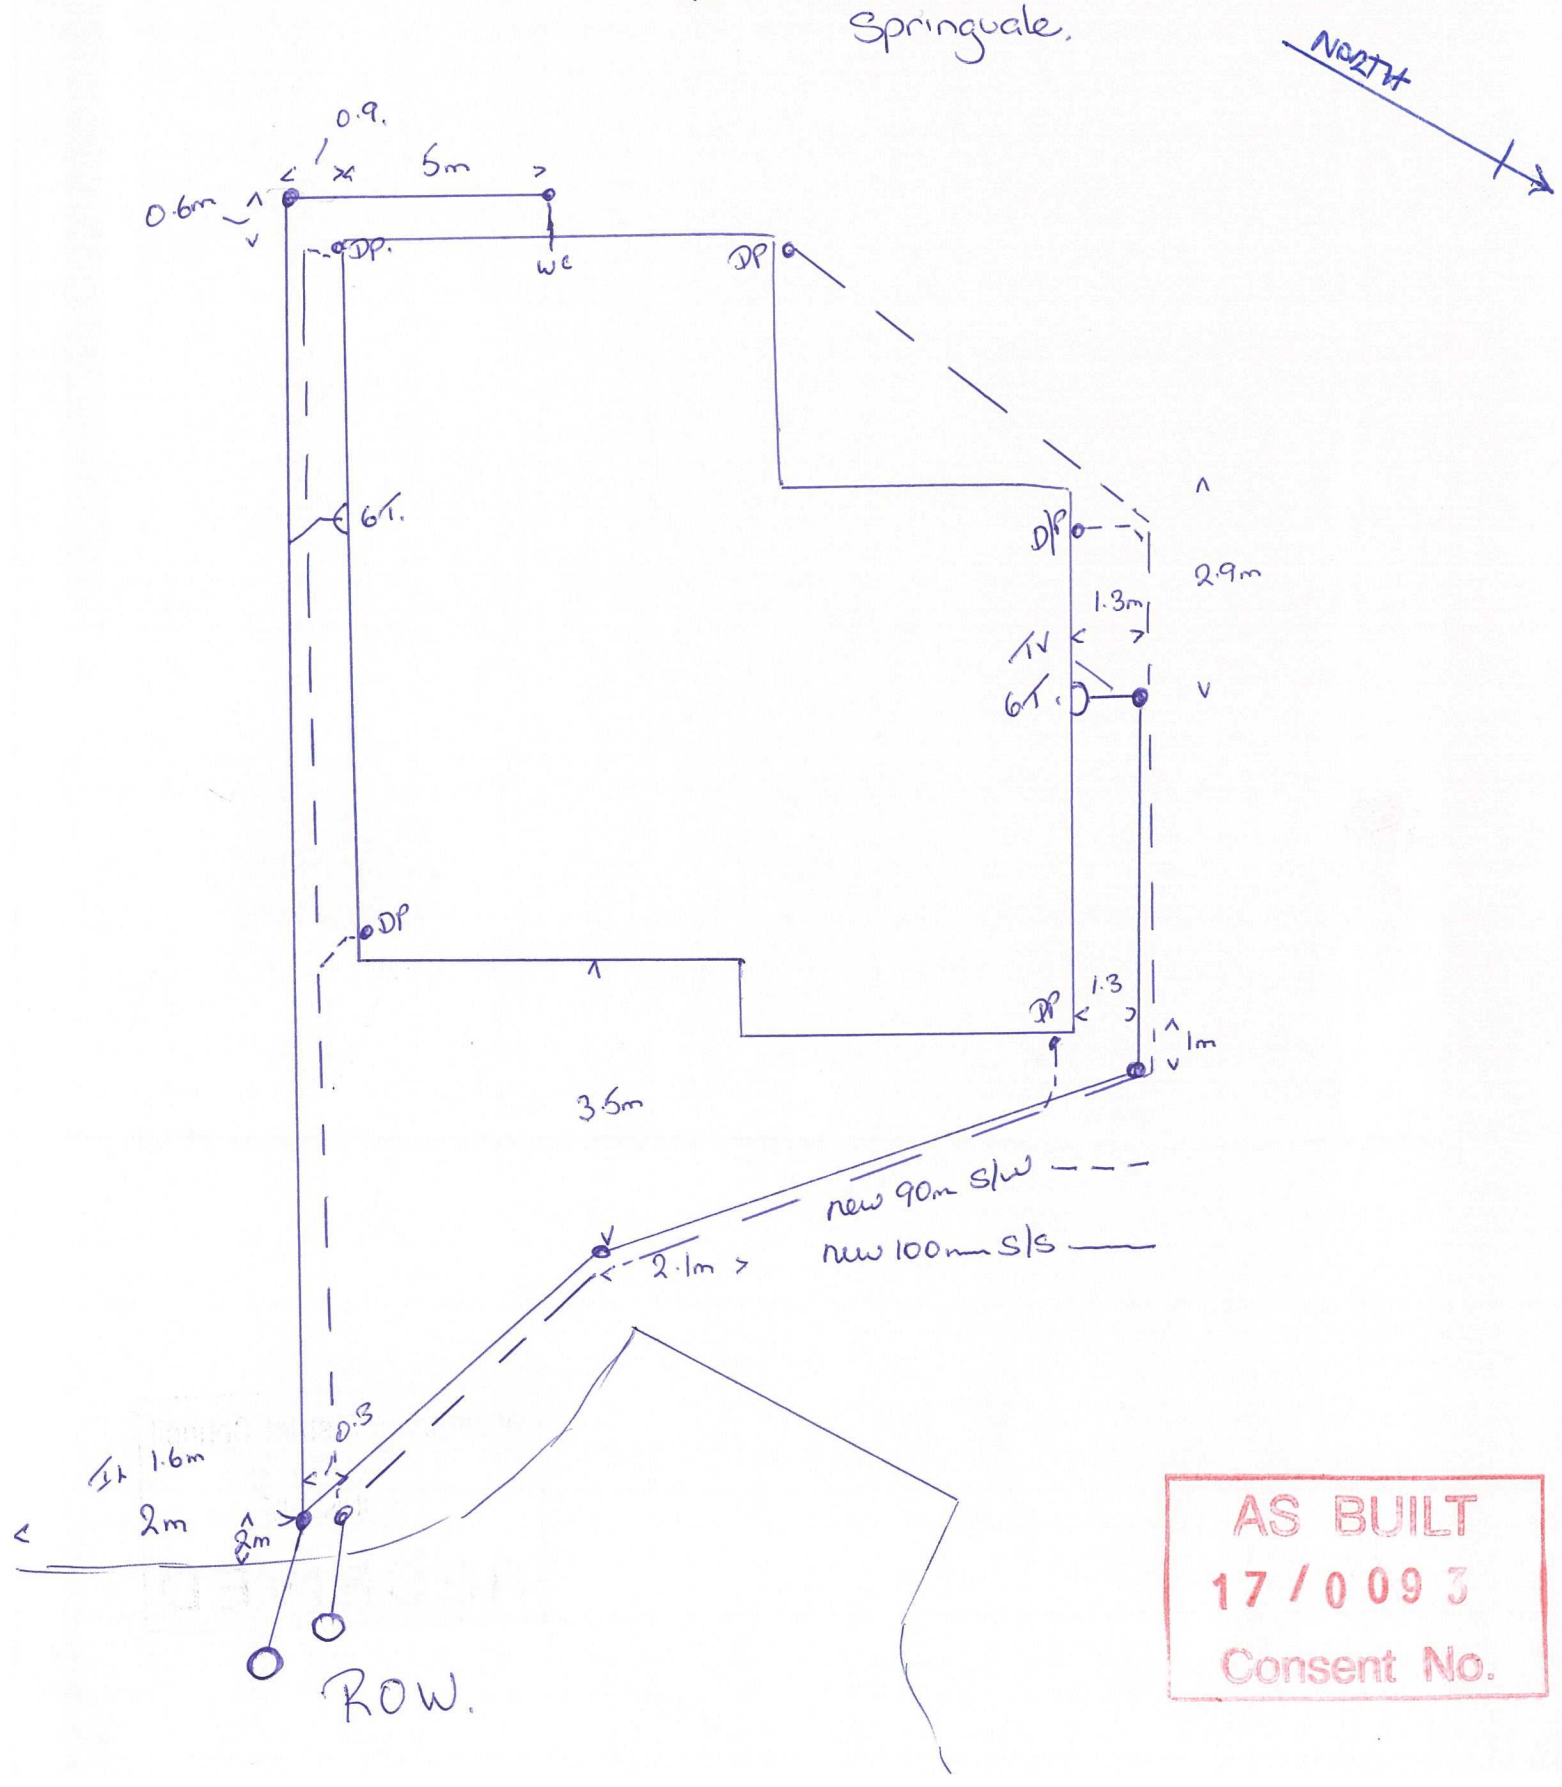

AS BUILT
17/0093
Consent No.